


Appendix 1B

Revised Carriageway Layout to Facilitate Heron Tower Construction

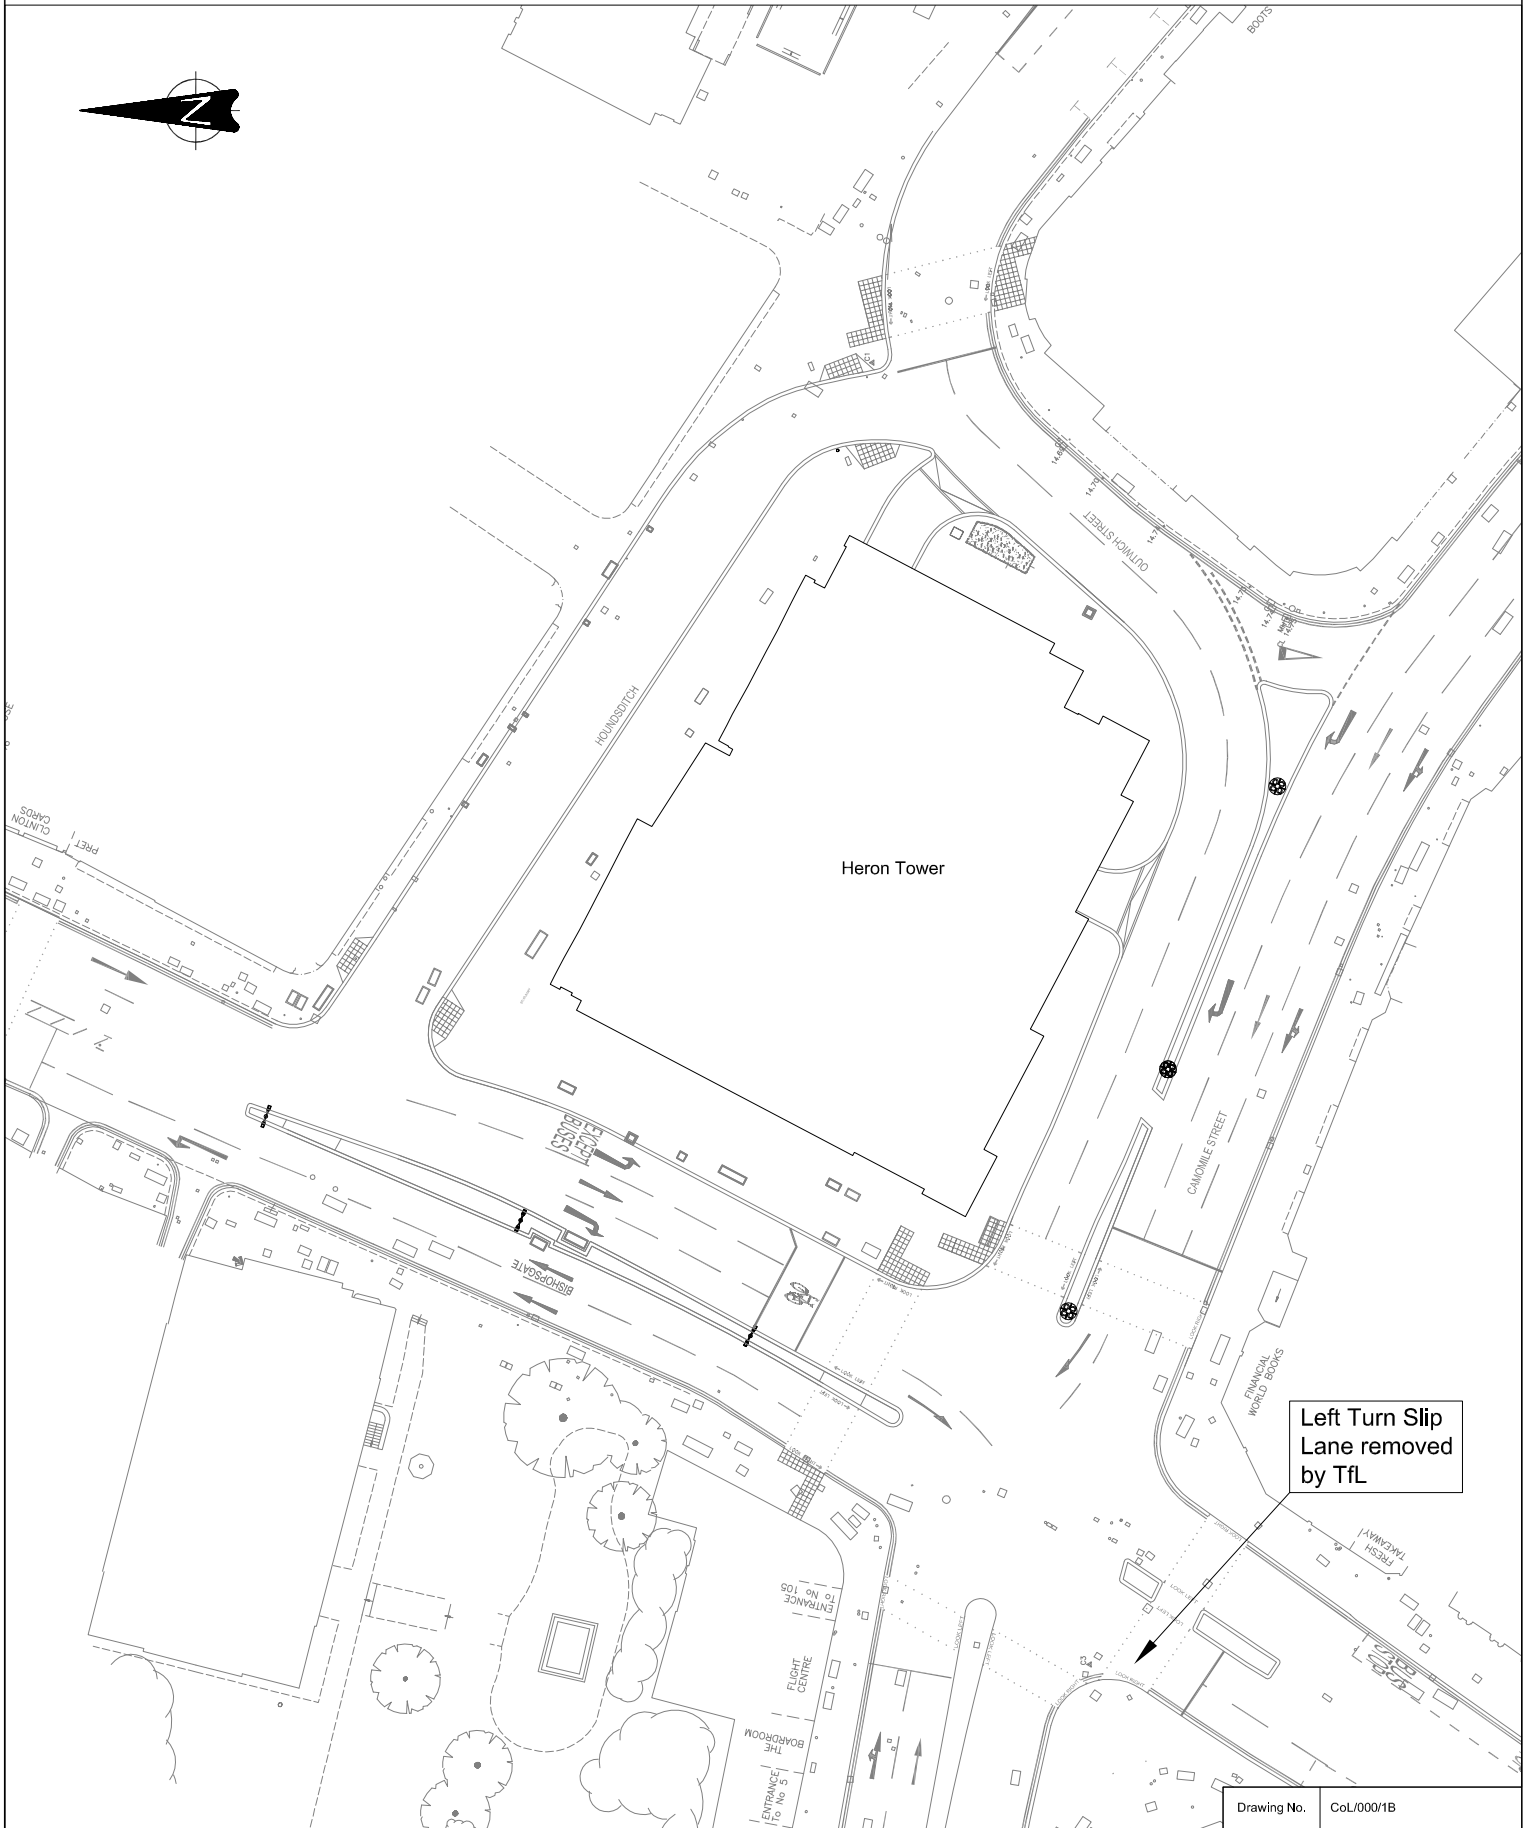

Left Turn Slip Lane removed by TfL

Name KM	Project Heron Tower S278 (1) As Built Drawing	Title General Arrangement
Scale N.T.S		
Date Jan 2013		

Drawing No. CoL/000/1B

