

FIRE SAFETY LEGEND

	FIRE ALARM CALL POINT
	9 LITRE WATER FIRE EXTINGUISHER
	2 KG CARBON DIOXIDE EXTINGUISHER (OR HALON)
	9 LITRE FOAM FIRE EXTINGUISHER
	FIRE BLANKET IN CONTAINER
	AREA COVERED BY AUTOMATIC HEAT DETECTORS
	AREA COVERED BY AUTOMATIC SMOKE DETECTORS
	AREA COVERED BY EMERGENCY LIGHTING (BS 5266)
	PANIC BAR TO BE PROVIDED TO DOORS
	DOORS TO HAVE ONLY A SIMPLE FASTENING WITHOUT USE OF A KEY E.G. BARREL BOLT, NIGHT LATCH SIGN, 'FIRE DOOR KEEP SHUT', 5MM LETTERS (BOTH SIDES OF DOOR)
	SIGN, 'FIRE DOOR KEEP SHUT'
	SIGN, 'FIRE DOOR KEEP LOCKED'
	SIGN, 'FIRE ESCAPE KEEP CLEAR'
	SIGN, 'FIRE EXIT' OR GRAPHIC EQUIVALENT 75MM LETTERS
	DIRECTIONAL ARROW TO BE PROVIDED WITH S22 NOTICE
	ILLUMINATED SIGN - 'FIRE EXIT' OR GRAPHIC EQUIVALENT 75MM LETTERS
	FIRE ALARM SOUNDER
	FD30 S 30 MINS FIRE PROTECTED DOOR W/ SMOKE SEALANTS

GENERAL FIRE NOTES

- DOORS THAT ARE REQUIRED TO PROVIDE 30 STANDARD OF FIRE MINUTES RESISTANCE TO BS 476 PART 22.
- GLAZING TO DOORS, TO HAVE 30 MINUTES STANDARD OF FIRE RESISTANCE TO BS 476: PART 22
- ALL DOORS ON ESCAPE ROUTES TO BE FITTED WITH SIMPLE FASTENINGS OPENABLE FROM THE ESCAPE SIDE OPENABLE FROM THE ESCAPE SIDE WITHOUT THE USE OF A KEY.
- ALL EXIT SIGNS MUST COMPLY WITH BS5499: PART 1:1990 19. ALL FIRE DOORS FD.30 TO BE FITTED WITH A 25MM HARDWOOD DOOR CHECK GLUED AND SCREWED TO THE DOOR FRAME
- ALL DEMOLITION TO BE CARRIED OUT IN ACCORDANCE WITH THE HEALTH AND SAFETY AT WORK ET ACT AND BS 6187
- EMERGENCY LIGHTING TO BE PROVIDED IN THE ESCAPE STAIR AND ON A PROTECTED CIRCUIT FROM THAT SUPPLYING ANY OTHER PART OF THE ESCAPE ROUTE. EMERGENCY LIGHTING TO COMPLY WITH BS 5266 PT.1:1988 (MAINTAINED 3 HOURS DURATION)
- FABRIC TO UPHOLSTERED FURNITURE TO MEET IGNITION SOURCE 5 TEST TO COMPLY WITH BS PT.2.1982.
- FIRE WARNING SYSTEM TO COMPLY WITH BS 5839 PT.1:1988
- FIRE FIGHTING EQUIPMENT TO COMPLY WITH BS 5423 PT.1:1987 DURATION)
- FIRE SIGNS AND NOTICES TO COMPLY WITH BS 5499 PT.1:1990
- ALL ILLUMINATED EXIT SIGNS AND EMERGENCY LIGHTING TO BE FULLY MAINTAINED.

As approved by the Fire Officer for fire to have

COVERS

TYPE	QUANTITY
RESTAURANT SEATING	80
CAFE SEATING	20
TOTAL	100 COVERS

WALL LEGEND

SYMBOL	DESCRIPTION
	EXISTING WALL
	NEW FULL HEIGHT CONSTRUCTION 1hr FR & INSULATION
	NEW FULL HEIGHT WALL

AREA - SQM

AREA	SQM
GROUND FLOOR	
RESTAURANT	133
KITCHEN/ STORES	3
PASSAGEWAYS/ WCs	27
TOTAL GROUND FLOOR	163
BASEMENT	
RESTAURANT	0
KITCHEN/ STORES	330
PASSAGEWAYS/ WCs	110
TOTAL BASEMENT	440
TOTAL	603 SQM

LICENSING LEGEND

	DRINKING AREAS (INCL. BARS)
	LIQUOR STORAGE
	KITCHEN AND STAFF AREAS
	WC, PASSAGEWAYS ETC
	AMBIT OF LICENSED PREMISES

CITY OF LONDON

PLAN No. ~~6004-14A~~
 APPROVED ON ~~22/10~~
~~REPLANT (PROVISIONAL)~~
 MODIFICATIONS s.6 (3)
 ALTERATIONS s.20

GSM
 Clerk/Chairman
 Licensing Justices



REVISIONS

Rev.	Date	Comment
A.	23.06.04	DESIGN REVISION BAR ADDED FURNITURE PLAN CHANGES

© MARTIN BRUDNIZKI DESIGN STUDIO LTD 2003

- ### NOTES
- THE DRAWING SHOW DESIGN INTENT ONLY. ALL DIMENSIONS TO BE CHECKED ON SITE PRIOR TO CONSTRUCTION OR PRODUCTION. CONSTRUCTION DETAILS TO BE CONFIRMED BY CONTRACTOR/MANUFACTURER BY SUBMITTING SHOP DRAWINGS FOR DESIGNER'S APPROVAL.
 - DESIGN / DRAWING IS NOT TO BE SCALED FOR PRODUCTION AND CONSTRUCTION PURPOSES
 - ALL DISCREPANCIES AND OMISSIONS ON SITE MUST BE REPORTED TO DESIGNER FOR THEIR COMMENTS OR APPROVAL PRIOR TO COMMENCING WORK
 - ALL ELECTRICAL, LIGHTING, HVAC AND PLUMBING ISSUES TO BE REFERRED TO ENGINEER'S DRAWINGS PRIOR TO COMMENCEMENT OF WORKS.
 - THE DESIGNS ARE SUBJECT TO APPROVAL BY STATUTORY AUTHORITIES AND ANY NECESSARY ALTERATIONS SHOULD BE MADE IF REQUIRED TO COMPLY WITH STATUTORY REQUIREMENTS.
 - ALL DESIGN CONCEPTS AND DRAWINGS ARE THE PROPERTY OF MARTIN BRUDNIZKI AND ARE COVERED BY COPYRIGHT. NO REPRODUCTIONS, ADAPTATIONS AND/OR COPIES MAY BE MADE WITHOUT WRITTEN PERMISSION BY MARTIN BRUDNIZKI.

LICENSING

Project
 No 4 ST PAULS CHURCHYARD
 Title
 PLAN PROPOSALS
 PAGE 1 OF 2
 Date 23.06.04 Scale 1:100@A3
 Drwg No 6004-L4 Rev. A Auto Cad ref


MARTIN BRUDNIZKI
 DESIGN STUDIO LTD
 Unit 2L Chelsea Reach
 79-89 Lots Road London SW10 0RN
 Tel +44 (0)20 7376 7555
 Fax +44 (0)20 7376 7444

FIRE SAFETY LEGEND

- FIRE ALARM CALL POINT
- 9 LITRE WATER FIRE EXTINGUISHER
- 2 KG CARBON DIOXIDE EXTINGUISHER (OR HALON)
- 9 LITRE FOAM FIRE EXTINGUISHER
- FIRE BLANKET IN CONTAINER
- AREA COVERED BY AUTOMATIC HEAT DETECTORS
- AREA COVERED BY AUTOMATIC SMOKE DETECTORS
- AREA COVERED BY EMERGENCY LIGHTING (BS 5265)
- PANIC BAR TO BE PROVIDED TO DOORS
- DOORS TO HAVE ONLY A SIMPLE FASTENING WITHOUT USE OF A KEY. E.G. BARREL BOLT, NIGHT LATCH
- SIGN, 'FIRE DOOR KEEP SHUT', 5MM LETTERS (BOTH SIDES OF DOOR)
- SIGN, 'FIRE DOOR KEEP LOCKED'
- SIGN, 'FIRE ESCAPE KEEP CLEAR'
- SIGN, 'FIRE EXIT' OR GRAPHIC EQUIVALENT 75MM LETTERS
- DIRECTIONAL ARROW TO BE PROVIDED WITH S22 NOTICE
- ILLUMINATED SIGN - 'FIRE EXIT' OR GRAPHIC EQUIVALENT 75MM LETTERS
- FIRE ALARM SOUNDER
- 30 MINS FIRE PROTECTED DOOR W/ SMOKE SEALANTS

LICENSING LEGEND

- DRINKING AREAS (INCL. BARS)
- LIQUOR STORAGE
- KITCHEN AND STAFF AREAS
- WC, PASSAGEWAYS ETC
- AMBIT OF LICENSED PREMISES

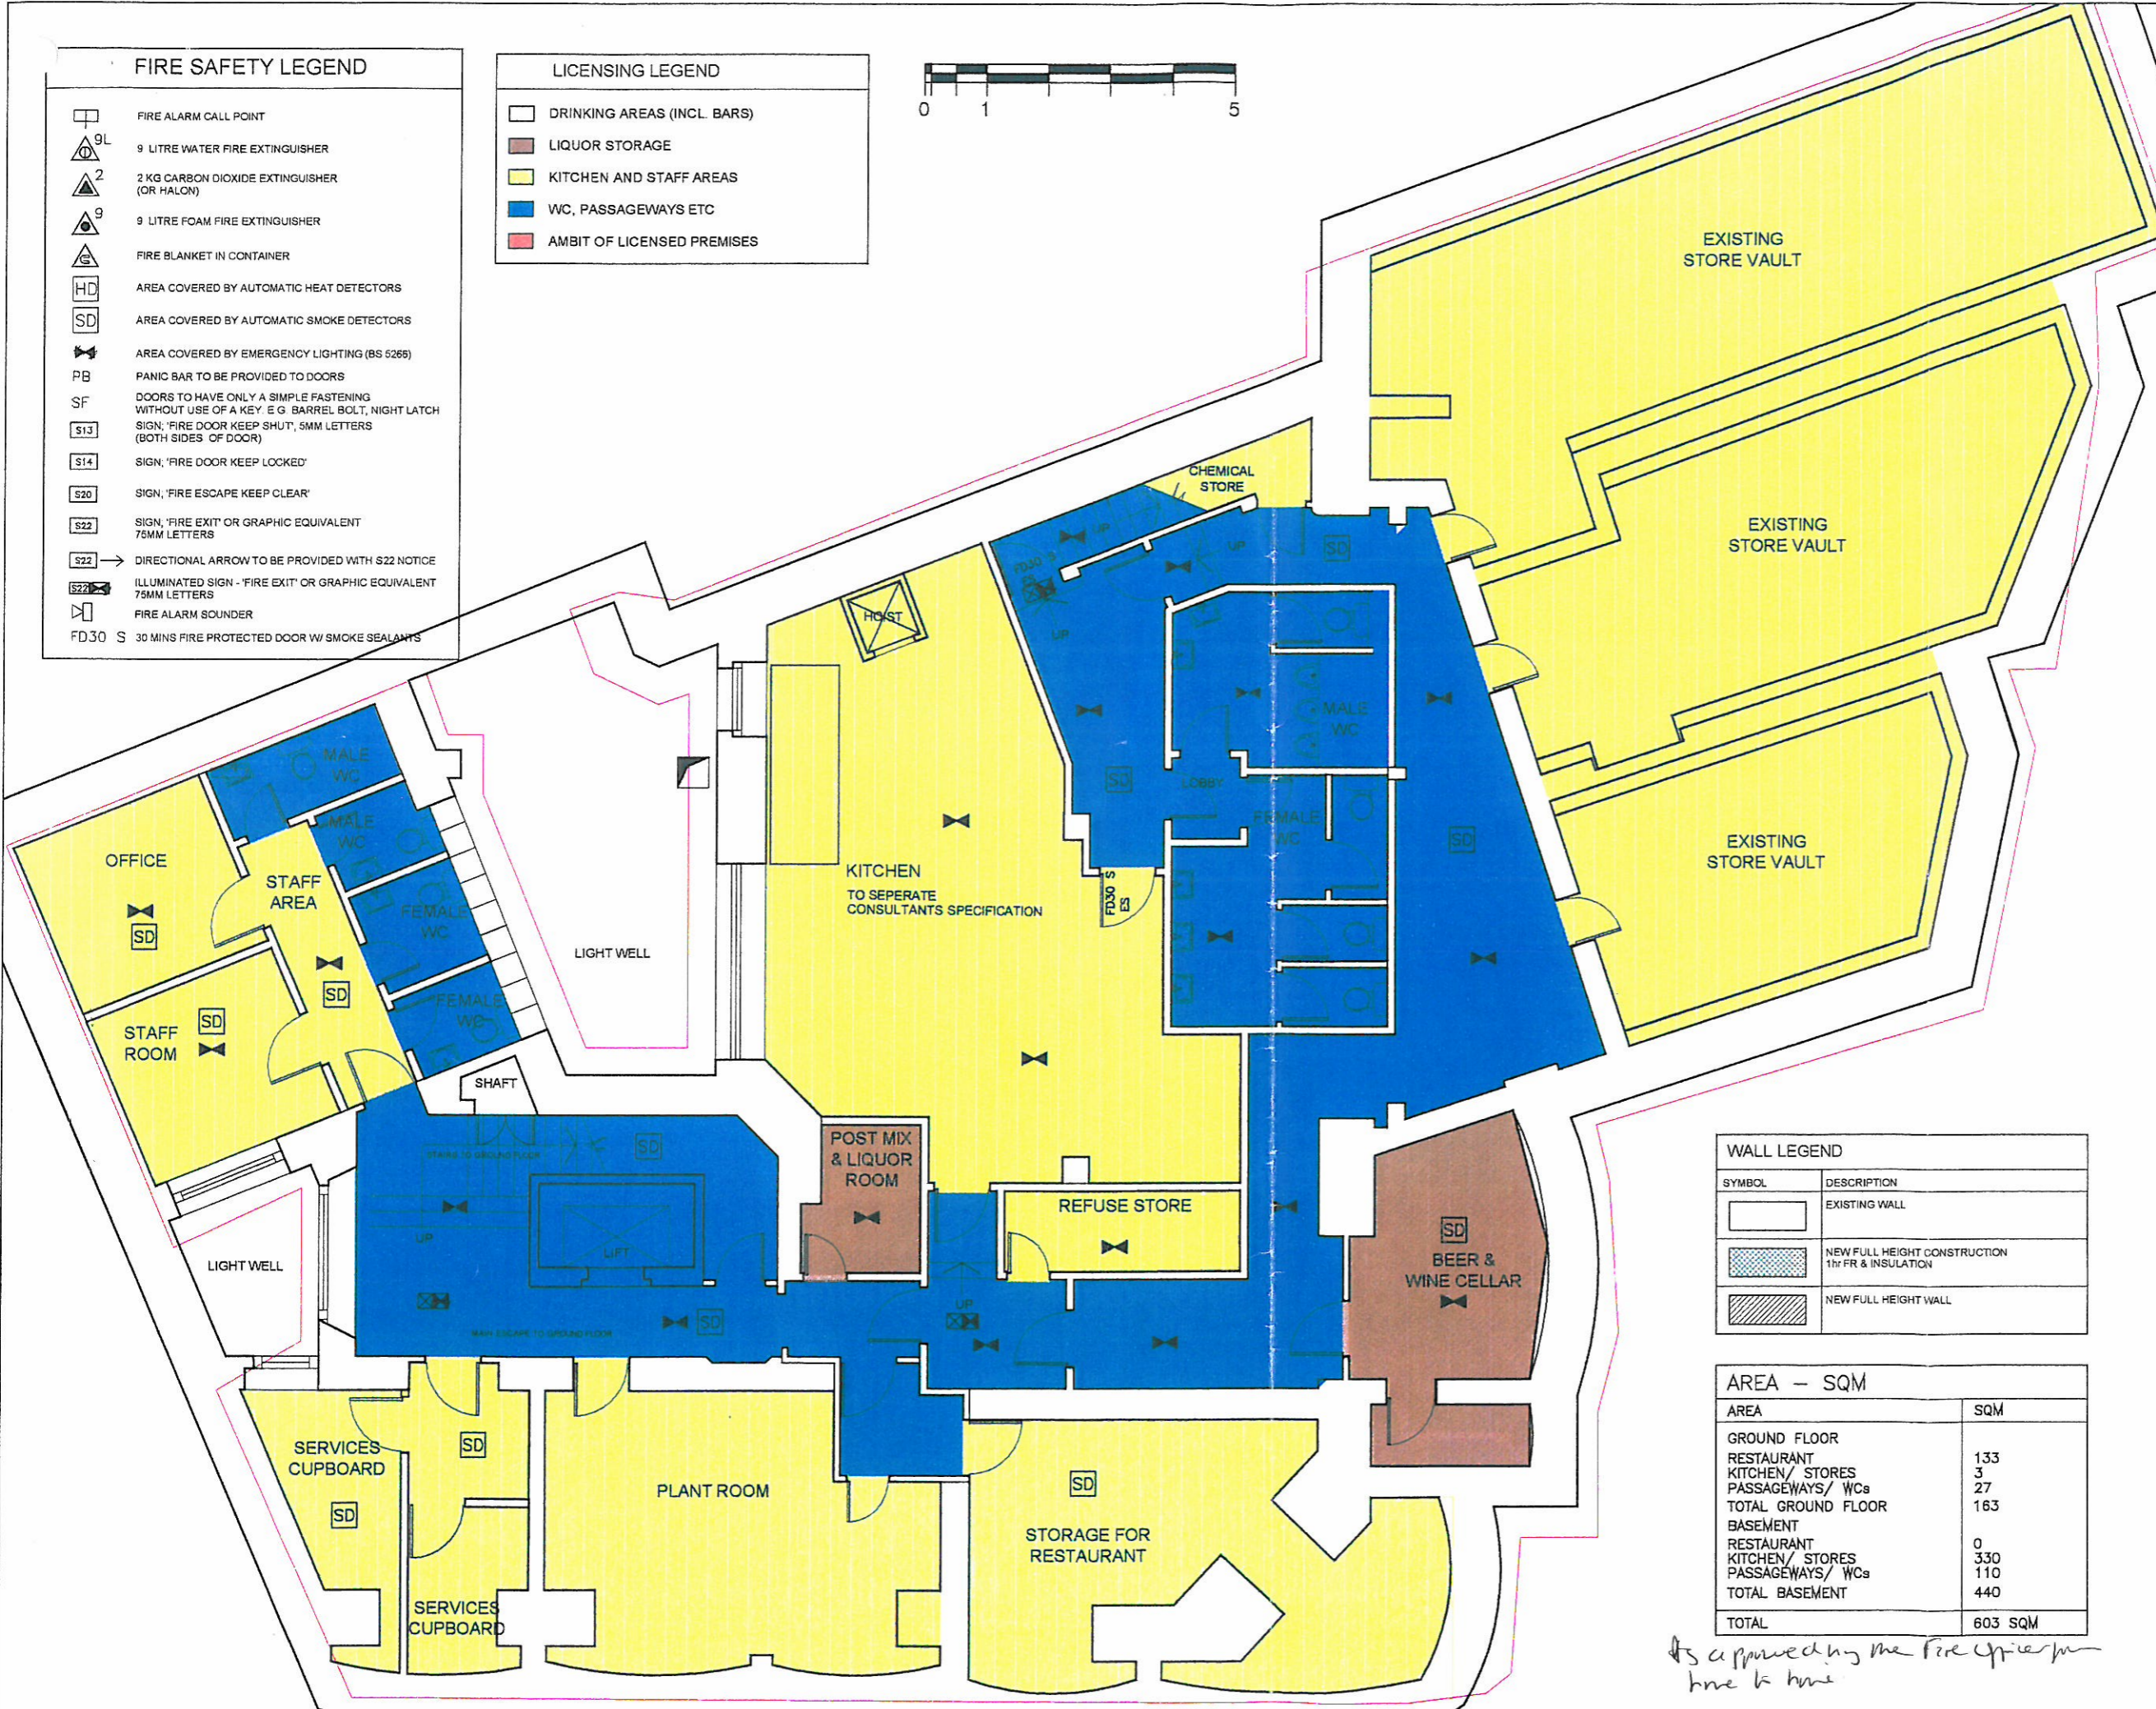

REVISIONS

Rev.	Date	Comment
A.	23.06.04	DESIGN REVISION BAR ADDED FURNITURE PLAN CHANGED

© MARTIN BRUDNIZKI DESIGN STUDIO LTD 2003

NOTES

1. THE DRAWING SHOW DESIGN INTENT ONLY. ALL DIMENSIONS TO BE CHECKED ON SITE PRIOR TO CONSTRUCTION OR PRODUCTION CONSTRUCTION DETAILS TO BE CONFIRMED BY CONTRACTOR/MANUFACTURER BY SUBMITTING SHOP DRAWINGS FOR DESIGNER'S APPROVAL.
2. DESIGN / DRAWING IS NOT TO BE SCALED FOR PRODUCTION AND CONSTRUCTION PURPOSES
3. ALL DISCREPANCIES AND OMISSIONS ON SITE MUST BE REPORTED TO DESIGNER FOR THEIR COMMENTS OR APPROVAL PRIOR TO COMMENCING WORK.
4. ALL ELECTRICAL, LIGHTING, HVAC AND PLUMBING ISSUES TO BE REFERRED TO ENGINEER'S DRAWINGS PRIOR TO COMMENCEMENT OF WORKS.
5. THE DESIGNS ARE SUBJECT TO APPROVAL BY STATUTORY AUTHORITIES AND ANY NECESSARY ALTERATIONS SHOULD BE MADE IF REQUIRED TO COMPLY WITH STATUTORY REQUIREMENTS.
6. ALL DESIGN CONCEPTS AND DRAWINGS ARE THE PROPERTY OF MARTIN BRUDNIZKI AND ARE COVERED BY COPYRIGHT. NO REPRODUCTIONS, ADAPTATIONS AND/OR COPIES MAY BE MADE WITHOUT WRITTEN PERMISSION BY MARTIN BRUDNIZKI.

WALL LEGEND

SYMBOL	DESCRIPTION
	EXISTING WALL
	NEW FULL HEIGHT CONSTRUCTION 1hr FR & INSULATION
	NEW FULL HEIGHT WALL

AREA - SQM

AREA	SQM
GROUND FLOOR	
RESTAURANT	133
KITCHEN/ STORES	3
PASSAGEWAYS/ WCs	27
TOTAL GROUND FLOOR	163
BASEMENT	
RESTAURANT	0
KITCHEN/ STORES	330
PASSAGEWAYS/ WCs	110
TOTAL BASEMENT	440
TOTAL	603 SQM

*As approved by the Fire Officer
line to line*

Project
4 ST. PAUL'S CHURCHYARD

Title
PLAN PROPOSALS
PAGE 2 OF 2

Date 23.06.04 Scale 1:100@A3

Drwg No 6004-L4 Rev. A Auto Cad ref 6004\$

MARTIN BRUDNIZKI
DESIGN STUDIO LTD
Unit 2L Chelsea Reach
79-89 Lots Road London SW10 0RN
Tel +44 (0)20 7376 7555
Fax +44 (0)20 7376 7444